


	No.	0
	DATE	5-08
	ORIGINAL SHEET	
	SAMPLE PLAN REVISION	

	MADE	BY	DATE
	TRACED	XXX	XX-XX-XX
	CHECKED	XXX	XX-XX-XX
	SUPERVISED	XXX	XX-XX-XX

MUNICIPALITY

COUNTY

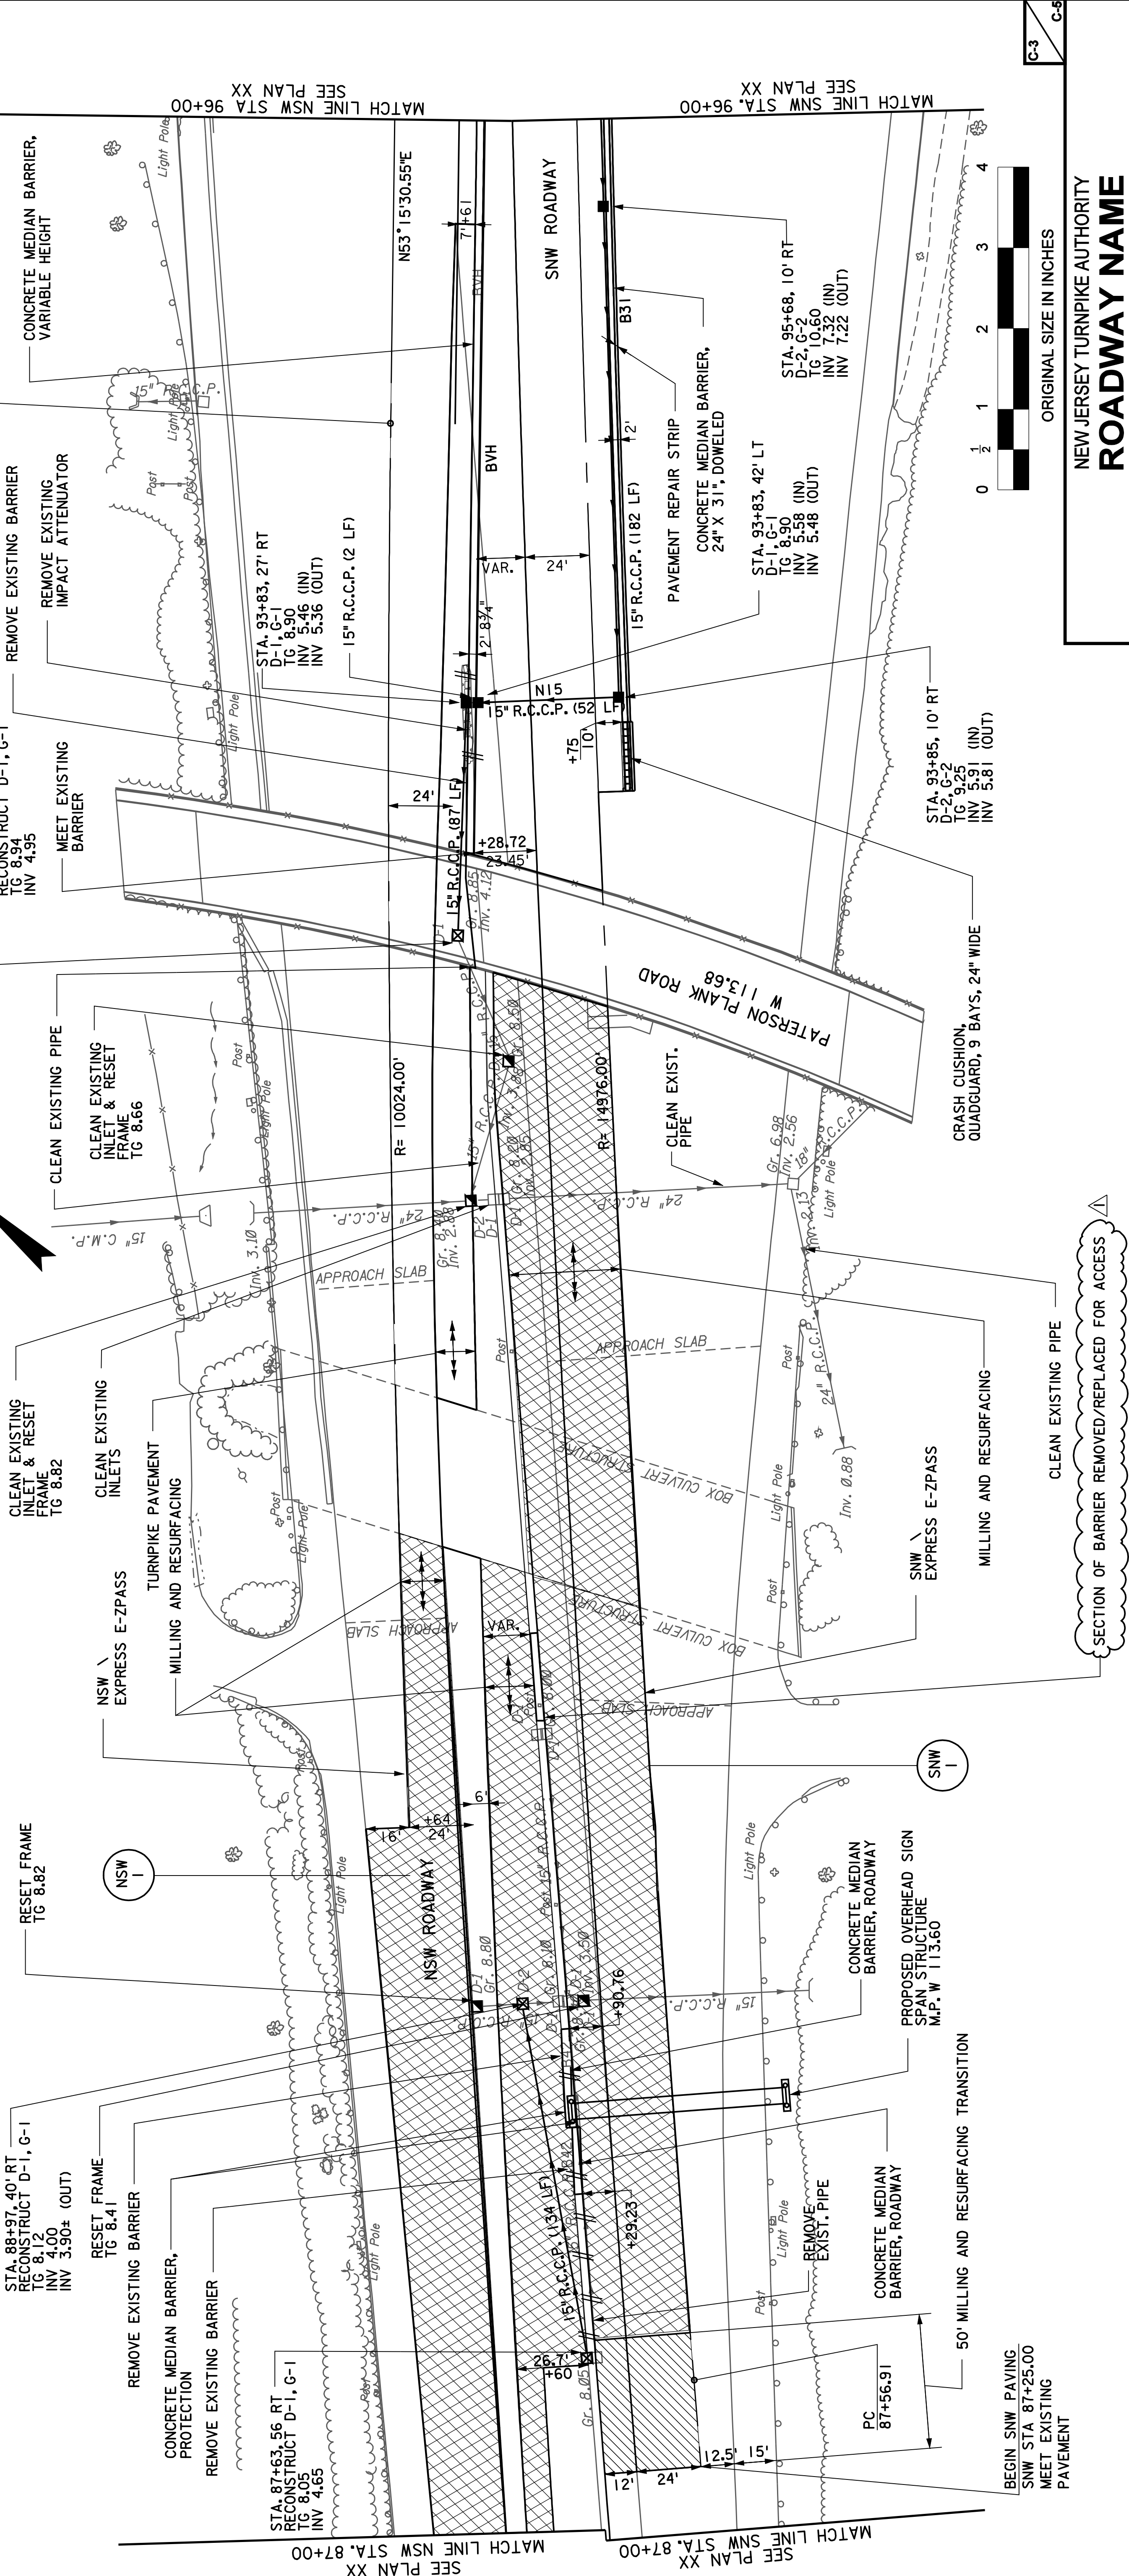

C-3

ORIGINAL SIZE IN INCHES

C-5

NEW JERSEY TURNPIKE AUTHORITY

ROADWAY NAME

PROJECT DESCRIPTION

CONTRACT NO.

CONSTRUCTION PLAN

-3-

AS-BUILT

NAME OF CONSULTANT

ADDRESS

CERTIFICATE OF AUTHORIZATION NO. XXXXXXXXX

JOHN DOE

NEW JERSEY PROFESSIONAL ENGINEER LICENSE NO. XXXXXXXXXX

FILE NAME: XXXXX

SCALE: 1" = 30'

DATE: MAY 2008

42

291

No.	X/XX	AS-BUILT	REVISION